


See attached. ALSO, for all reinforced sections, please show 12 inches of free draining aggregate behind back panel (not previously done). ALSO, for all reinforced sections, please extend top of filter fabric to back of coping as shown. Remove hatch inside connector.

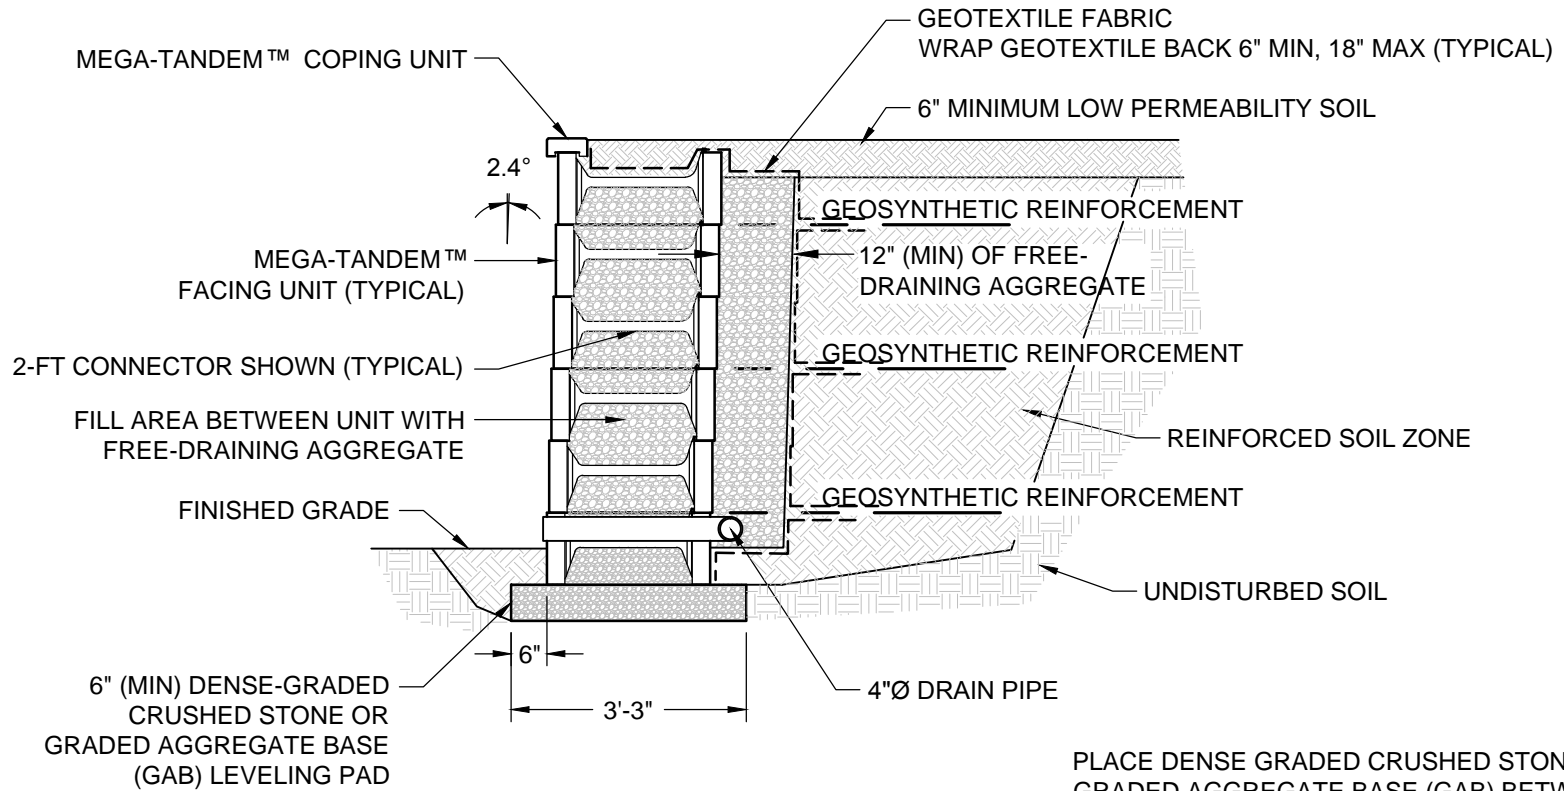

PLACE DENSE GRADED CRUSHED STONE OR GRADED AGGREGATE BASE (GAB) BETWEEN FACING UNITS BELOW THE FINISHED GRADE TO DAYLIGHT DRAIN PIPE THROUGH WALL FACE.



belgard.com
877-235-4273
details@belgard.com

This drawing is for illustrative purposes only and should not be used for construction without the signature of a registered professional engineer.

MEGA-TANDEM™
TYPICAL REINFORCED WALL SECTION

Scale:	None	Drawn by:	LM
Date:	2/24/2016	Drawing number:	MT06